


- ### KEYNOTES
- 006 FLUSH WALK-OFF MAT ENTIRE VESTIBULE
 - 017 DIGITAL SIGNAGE. REFER TO INTERIORS AND TECHNOLOGY DRAWINGS
 - 020 GREASE TRAP REFER TO PLUMBING DRAWINGS
 - 028 GALV HANDRAILS
 - 034 GUEST SAFETY DEPOSIT BOXES
 - 036 FLOOR SINK REFER TO PLUMBING DRAWINGS
 - 045 HIGH/LOW DRINKING FOUNTAIN. REFER TO PLUMBING DRAWINGS
 - 048 FOOD SERVICE EQUIPMENT SHOWN FOR REFERENCE ONLY. REFER TO FOOD SERVICE DRAWINGS
 - 055 FULL HEIGHT METAL SHELVING
 - 060 CONCRETE CURB
 - 066 TRANSACTION COUNTERPASS THRU WINDOW
 - 068 GLAZED PASS THRU WINDOW
 - 083 PLASTIC LAMINATE COUNTER TOP W/ ADJUSTABLE SHELF BASE CABINET
 - 089 STONE COUNTER
 - 108 FOOT OPERATED EYE WASH STATION, OSHA COMPLIANT
 - 122 PLASTIC LAMINATE COUNTER TOP
 - 300 INTERIOR FINISH. REFER TO INTERIOR DESIGN DOCUMENTS
 - 304 REFER TO INTERIOR DESIGN DRAWINGS FOR MILLWORK, FURNITURE, AND FINISHES THIS AREA L.I.C.D.
 - 324 FIRE COMMAND CENTER PANELS AT PARTITIONS
 - 325 WALL MOUNTED REMOTE ANNUNCIATOR PANELS
 - 530 LINE OF DEPRESSED SLAB. REFER TO STRUCTURAL AND/OR FLOOR SERVICE DRAWINGS

- Metropolitan Pier and Exposition Authority**
301 East Cermak Road, Chicago, IL 60616
- McCormick Place HQ Hotel**
2121 South Prairie Avenue, Chicago, IL 60616
- Goettsch Partners**
Architect
224 South Michigan Avenue, Suite 1700, Chicago, IL 60604
- Simeone Deary Design Group**
Interior Design
605 North Michigan Avenue, Suite 300, Chicago, IL 60611
- Magnusson Klemencic Associates, Inc.**
Structural Engineer
111 South Wacker Drive, Suite 1000, Chicago, IL 60606
- F.E. Moran**
Mechanical Design Build Contractor
226 Carlson Drive, Northbrook, IL 60062
- Cosentini Associates**
Electrical & Plumbing Engineer
1060 West Division Street, Chicago, IL 60642
- Great Lakes Plumbing and Heating**
Fire Protection Design Build Contractor
4521 West Diversy Avenue, Chicago, IL 60639
- Gibson**
Audio Visual, Security, & Telecommunications
3100 Woodstock Drive, Downers Grove, IL 60515
- Moody Nolan**
Associate Architect / LEED
209 South LaSalle Street, Suite 820, Chicago, IL 60604
- Site Design Group, Ltd.**
Landscape Design
888 South Michigan Avenue, Suite 1000, Chicago, IL 60605
- Terra Engineering, Ltd.**
Civil Engineer
225 West Ohio Street, 4th Floor, Chicago, IL 60654
- Anne Kustner Lighting Design, Ltd.**
Lighting Consultant
900 Isabelle Street, Evanston, IL 60201
- Catt Lyon Design + Wayfinding**
Wayfinding / Graphics
53 West Jackson Boulevard, Suite 382, Chicago, IL 60604
- Ricca Design Studios**
Food Service
5325 South Valerita Way, Greenwood Village, CO 80111
- Klein and Hoffman, Inc.**
Structural & Masonry Engineer (for ABC Building)
150 South Wacker Drive, Suite 1900, Chicago, IL 60606

- ### GENERAL NOTES
- A. ALL WALLS OF ROCK AREA ON LEVEL 01 TO BE CMU.
 - B. REFER TO SHEET A6.000 FOR REQUIRED STC RATINGS IN BALLROOM, MEETING ROOM, AND OFFICE PARTITIONS.
 - C. REFER TO G3 SERIES DRAWINGS FOR EGRESS AND OCCUPANCY PLANS.
 - D. SEE LANDSCAPE DRAWINGS FOR SIDEWALK SCORING COLOR AND FINISH.
 - E. SEE CIVIL DRAWINGS FOR SITE ELEVATIONS, DRIVEWAY AND CURB SECTIONS, AND UTILITY INFORMATION.
 - F. SEE CIVIL DRAWINGS FOR SIDEWALK HYDRANTS AND HOSE BIB LOCATIONS.
 - G. SEE ELECTRICAL DRAWINGS FOR PLANTER RECEPTACLES.
 - H. KITCHEN EQUIPMENT SHOWN FOR REFERENCE ONLY. REFER TO FOOD SERVICE DRAWINGS.
 - I. SEE FOOD SERVICE DWGS FOR EQUIPMENT BASE LOCATIONS WHERE REQUIRED. GC TO PROVIDE CONCRETE FILL AT EQUIPMENT BASE LOCATIONS.
 - J. DESIGNER/CLIENT TO ENSURE ALL WALLS AND/OR CEILINGS ARE PROPERLY REINFORCED TO SUPPORT ALL WALL/CILING FOOD SERVICE EQUIPMENT. SEE FOOD SERVICE DWGS.
 - K. PITCH FLOORS TO AREA DRAINS IN FOOD SERVICE AREAS. REFER TO FOOD SERVICE DWGS.
 - L. REFER TO G4.01 & G4.02 FOR BACK OF HOUSE FINISH SCHEDULE. REFER TO ID DRAWINGS FOR FRONT OF HOUSE FINISH SCHEDULE.
 - M. FOR INTERIOR BOH FINISHES REFER TO SHEETS G4.01 AND G4.02.
 - N. PROVIDE 6" CONCRETE CURB UNDER ALL FOOD PREPARATION AREA, COMED VAULT ROOM, AND ANY WET AREA PARTITIONS.
 - O. PROVIDE FIRE TREATED 4X8X3/4" PLYWOOD AS WALL PROTECTION AND STAINLESS STEEL CORNER GUARDS AT ALL SERVICE CORRIDORS.
 - P. PROVIDE LADDERS AND ACCESS PANELS FOR MECHANICAL MEZZANINES AS REQUIRED. PROVIDE GATED PANELS WHERE REQUIRED.
 - Q. SEE FOOD SERVICE DWGS FOR ALL REQUIRED SLAB DEPRESSIONS. COORDINATE AS REQUIRED. REFER TO A9 SERIES FOR EXTERIOR WALL AND WINDOW INFORMATION FOR ABC BUILDING.
 - S. PER SPEC 104413, FIRE PROTECTION CABINETS (FCO) TO BE LISTED AND LABELED TO COMPLY WITH REQUIREMENTS IN ASTM E814 FOR FIRE RESISTANCE RATING OF WALLS WHERE THEY ARE INSTALLED.

29 SEPTEMBER 2017
ISSUED FOR FINAL RECORD SET

- ### CONST. PLAN LEGEND
- 101 DOOR REFERENCE TYPE SEE SHEET A6.200 - A6.201
 - 11 WALL TYPE REFERENCE SEE SHEET A6.600
 - 04 KEYNOTE REFERENCE
 - - - INDICATES POURED CONC. CURB. SEE NOTE N

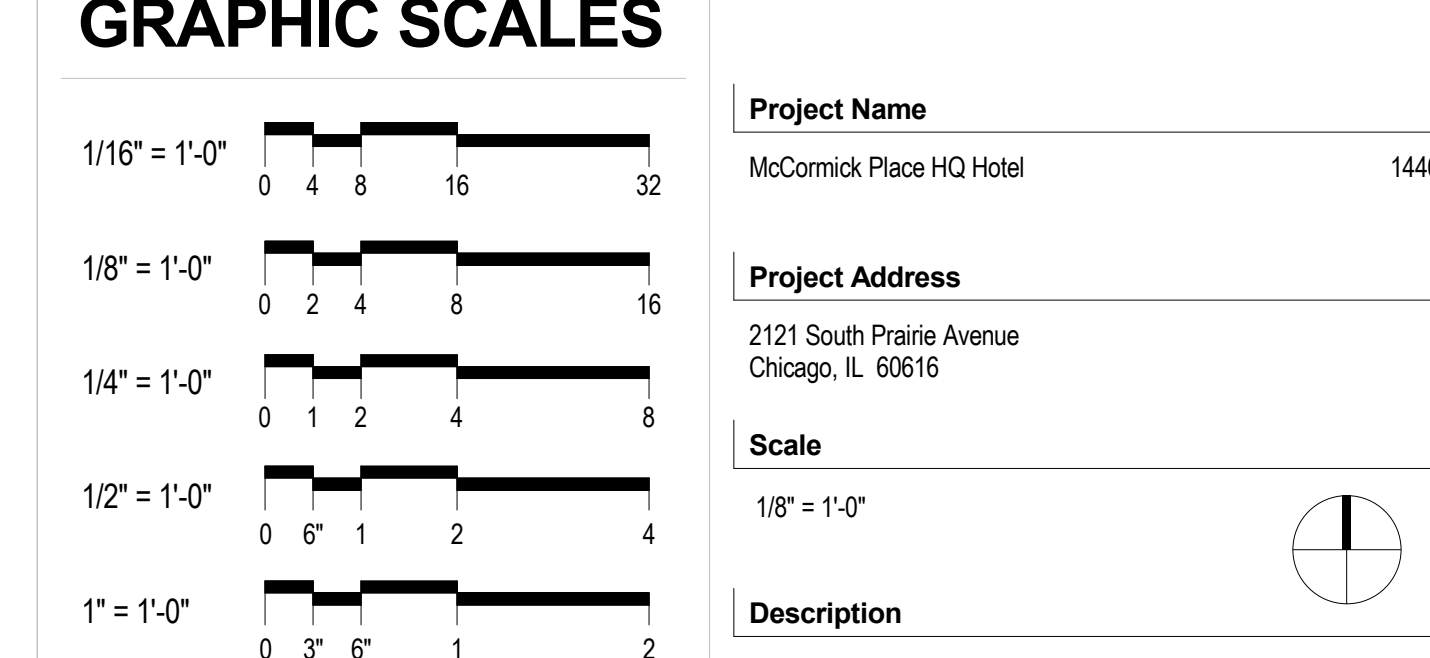

Project Name	McCormick Place HQ Hotel	14400
Project Address	2121 South Prairie Avenue Chicago, IL 60616	
Scale	1/8" = 1'-0"	
Description	FLOOR PLAN - LEVEL 01 - SEGMENT A	

1 CONSTRUCTION PLAN - LEVEL 01 - SEGMENT A
SCALE: 1/8" = 1'-0"

A1.101A