

**1** COMPOSITE PLAN - LEVEL LL1 / LEVEL LL1A  
SCALE: 1/16" = 1'-0"

**KEYNOTES**

- 056 NO PARKING ZONE PAINT STRIPING
- 085 COMED CONCRETE ENCASED CONDUIT

City Stamp	
<b>Metropolitan Pier and Exposition Authority</b> 301 East Cermak Road, Chicago, IL 60616	
<b>McCormick Place HQ Hotel</b> 2121 South Prairie Avenue, Chicago, IL 60616	
<b>Goettsch Partners</b> Architect 224 South Michigan Avenue, Suite 1700, Chicago, IL 60604	
<b>Simeone Deary Design Group</b> Interior Design 605 North Michigan Avenue, Suite 350, Chicago, IL 60611	
<b>Magnusson Klemencic Associates, Inc.</b> Structural Engineer 111 South Wacker Drive, Suite 3390, Chicago, IL 60606	
<b>F.E. Moran</b> Mechanical Design Build Contractor 226 Carlson Drive, Northbrook, IL 60062	
<b>Cosentini Associates</b> Electrical & Plumbing Engineer 1060 West Division Street, Chicago, IL 60642	
<b>Great Lakes Plumbing and Heating</b> Fire Protection Design Build Contractor 4521 West Diversy Avenue, Chicago, IL 60639	
<b>Gibson</b> Audio Visual, Security, & Telecommunications 3100 Woodstock Drive, Downers Grove, IL 60515	
<b>Moody Nolan</b> Associate Architect / LEED 209 South LaSalle Street, Suite 820, Chicago, IL 60604	
<b>Site Design Group, Ltd.</b> Landscape Design 888 South Michigan Avenue, Suite 1000, Chicago, IL 60605	
<b>Terra Engineering, Ltd.</b> Civil Engineer 225 West Ohio Street, 4th Floor, Chicago, IL 60654	
<b>Anne Kustner Lighting Design, Ltd.</b> Lighting Consultant 900 Isabelle Street, Evanston, IL 60201	
<b>Catt Lyon Design + Wayfinding</b> Wayfinding / Graphics 53 West Jackson Boulevard, Suite 362, Chicago, IL 60604	
<b>Ricca Design Studios</b> Food Service 5325 South Valerita Way, Greenwood Village, CO 80111	
<b>Klein and Hoffman, Inc.</b> Structural & Masonry Engineer (for ABC Building) 150 South Wacker Drive, Suite 1900, Chicago, IL 60606	


**GENERAL NOTES**

- A. ALL WALLS OF DOCK AREA ON LEVEL 01 TO BE CMU.
- B. REFER TO SHEET A6.003 FOR REQUIRED STC RATINGS AT BALLROOM, MEETING ROOM, AND OFFICE PARTITIONS.
- C. REFER TO S3 SERIES DRAWINGS FOR EGRESS AND OCCUPANCY PLANS.
- D. SEE LANDSCAPE DRAWINGS FOR SIDEWALK SCOURING COLOR AND FINISH.
- E. SEE CIVIL DRAWINGS FOR SITE ELEVATIONS, DRIVEWAY AND CURB SECTIONS, AND UTILITY INFORMATION.
- F. SEE CIVIL DRAWINGS FOR SIDEWALK HYDRANTS AND HOSE BIB LOCATIONS.
- G. SEE ELECTRICAL DRAWINGS FOR PLANTER RECEPTACLES.
- H. KITCHEN EQUIPMENT SHOWN FOR REFERENCE ONLY. REFER TO FOOD SERVICE DRAWINGS.
- I. SEE FOOD SERVICE DWGS FOR EQUIPMENT BASE LOCATIONS WHERE REQUIRED. GC TO PROVIDE CONCRETE FILL AT EQUIPMENT BASE LOCATIONS.
- J. DESIGN/ORDER TO ENSURE ALL WALLS AND/OR CEILING ARE PROPERLY REINFORCED TO SUPPORT ALL WALL/CILING FOOD SERVICE EQUIPMENT. SEE FOOD SERVICE DWGS.
- K. PITCH FLOORS TO AREA DRAINS IN FOOD SERVICE AREAS. REFER TO FOOD SERVICE DWGS.
- L. REFER TO G0.411 & G0.402 FOR BACK OF HOUSE FINISH SCHEDULE. REFER TO ID DRAWINGS FOR FRONT OF HOUSE FINISH SCHEDULE.
- M. FOR INTERIOR BOB FINISHES REFER TO SHEETS G0.401 AND G0.402.
- N. PROVIDE 6" CONCRETE CURB UNDER ALL FOOD PREPARATION AREA, COMED WALK ROOM, AND ANY WET AREA PARTITIONS.
- O. PROVIDE FIRE TREATED 4X12X3/4" PLYWOOD AS WALL PROTECTION AND STAINLESS STEEL CORNER GUARDS AT ALL SERVICE CORRIDORS.
- P. PROVIDE LADDERS AND ACCESS PANELS FOR MECHANICAL MEZZANINES AS REQUIRED. PROVIDE RATED PANELS WHERE REQUIRED.
- Q. SEE FOOD SERVICE DWGS FOR ALL REQUIRED SUB DEPRESSIONS. COORDINATE AS REQUIRED.
- R. REFER TO AS SERIES FOR EXTERIOR WALL AND WINDOW INFORMATION FOR ABC BUILDING.
- S. PER SPEC 104413, FIRE PROTECTION CABINETS (PFCAB) TO BE USED AND LABELED TO COMPLY WITH REQUIREMENTS IN ASTM E814 FOR FIRE RESISTANCE RATING OF WALLS WHERE THEY ARE INSTALLED.

**CONST. PLAN LEGEND**

- 101 DOOR REFERENCE TYPE (SEE SHEET A6.200 - A6.201)
- 11 WALL TYPE REFERENCE (SEE SHEET A6.600)
- 04 KEYNOTE REFERENCE
- - - INDICATES POURED CONC. CURR. (SEE NOTE N)


**GRAPHIC SCALES**

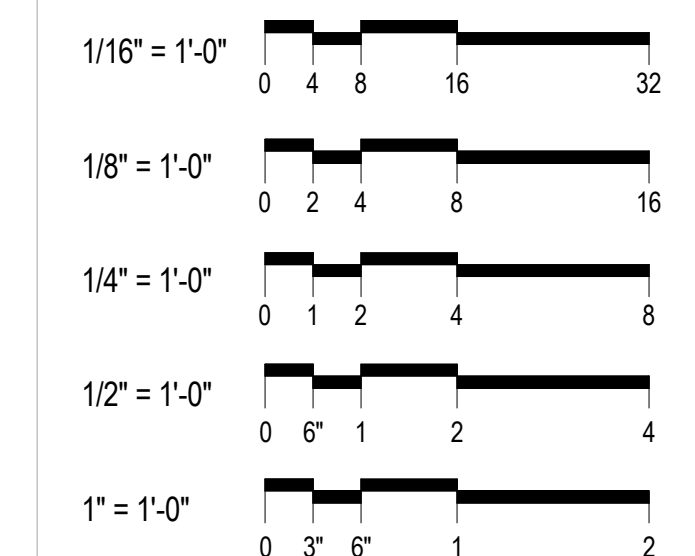

Date	Description
31 Jan 2015	ISSUED FOR 50% DD
20 Mar 2015	ISSUED FOR FOUNDATION PERMIT
01 May 2015	O.U.C. REVIEW
20 May 2015	O.U.C. REVIEW 2
01 Jun 2015	ISSUED FOR 60% CD
29 Jun 2015	ISSUED FOR CAISSON PERMIT
01 Aug 2015	ISSUED FOR FULL BUILDING PERMIT
19 Aug 2015	FOUNDATION PERMIT CORRECTIONS 3
15 Sep 2015	INTERIOR BID SET
16 Oct 2015	ISSUED FOR 100% CD
22 Jan 2016	BULLETIN 8
25 Mar 2016	BULLETIN 8
25 Apr 2016	BULLETIN 9
01 Jun 2016	BULLETIN 11
06 Jul 2016	BULLETIN 14
27 Jul 2016	BULLETIN 15
29 Aug 2016	BULLETIN 16
29 Sep 2016	BULLETIN 17
03 Nov 2016	BULLETIN 18
12 Jan 2017	BULLETIN 20
16 Feb 2017	BULLETIN 21

Seal / Signature  
**29 SEPTEMBER 2017**  
ISSUED FOR FINAL  
RECORD SET

**KEY PLAN**

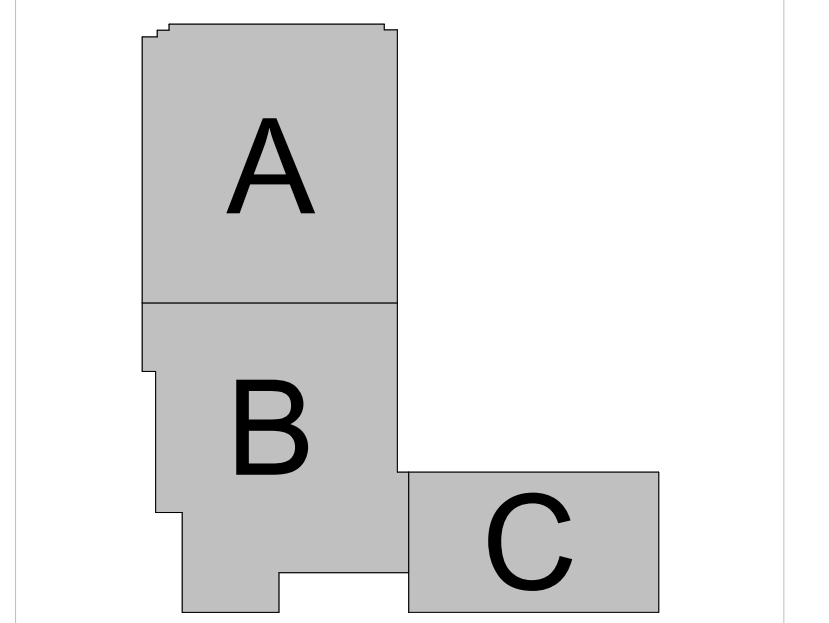

Project Name	McCormick Place HQ Hotel	14400
Project Address	2121 South Prairie Avenue Chicago, IL 60616	
Scale	As indicated	
Description	OVERALL PLAN - LEVEL LL1	

**A1.10LL1**